


108x57

- GENERAL NOTES:
- 1) SEE SHEET 2 FOR OVERALL DIMENSIONS OF BUILDING 26.
 - 2) ALL INTERIOR ANGLES OF CONDOMINIUMS ARE 90 DEGREES OR AS SHOWN.
 - 3) EACH CONDOMINIUM UNIT CONSISTS OF SPACE BOUNDED BY A VERTICAL PROJECTION OF THE CONDOMINIUM UNIT BOUNDARY LINES AS SHOWN BY THE HORIZONTAL PLANES AT THE FLOOR AND CEILING ELEVATIONS OR AS SHOWN.


LEGEND
4820 - UNIT ADDRESS

Recorded in Condo Book
No. 108 Page 59

Recorded in Condo Book
No. 108 Page 59

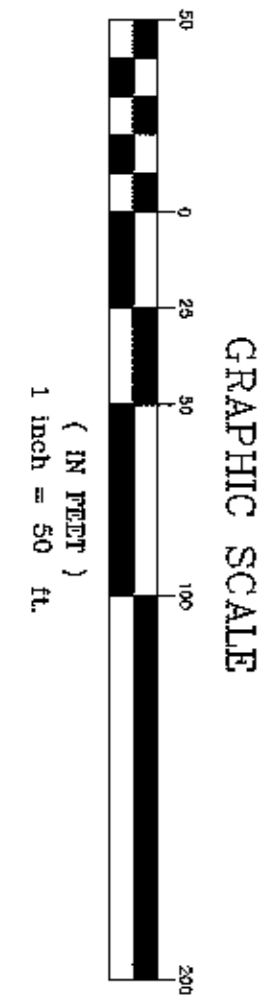


108 x 51

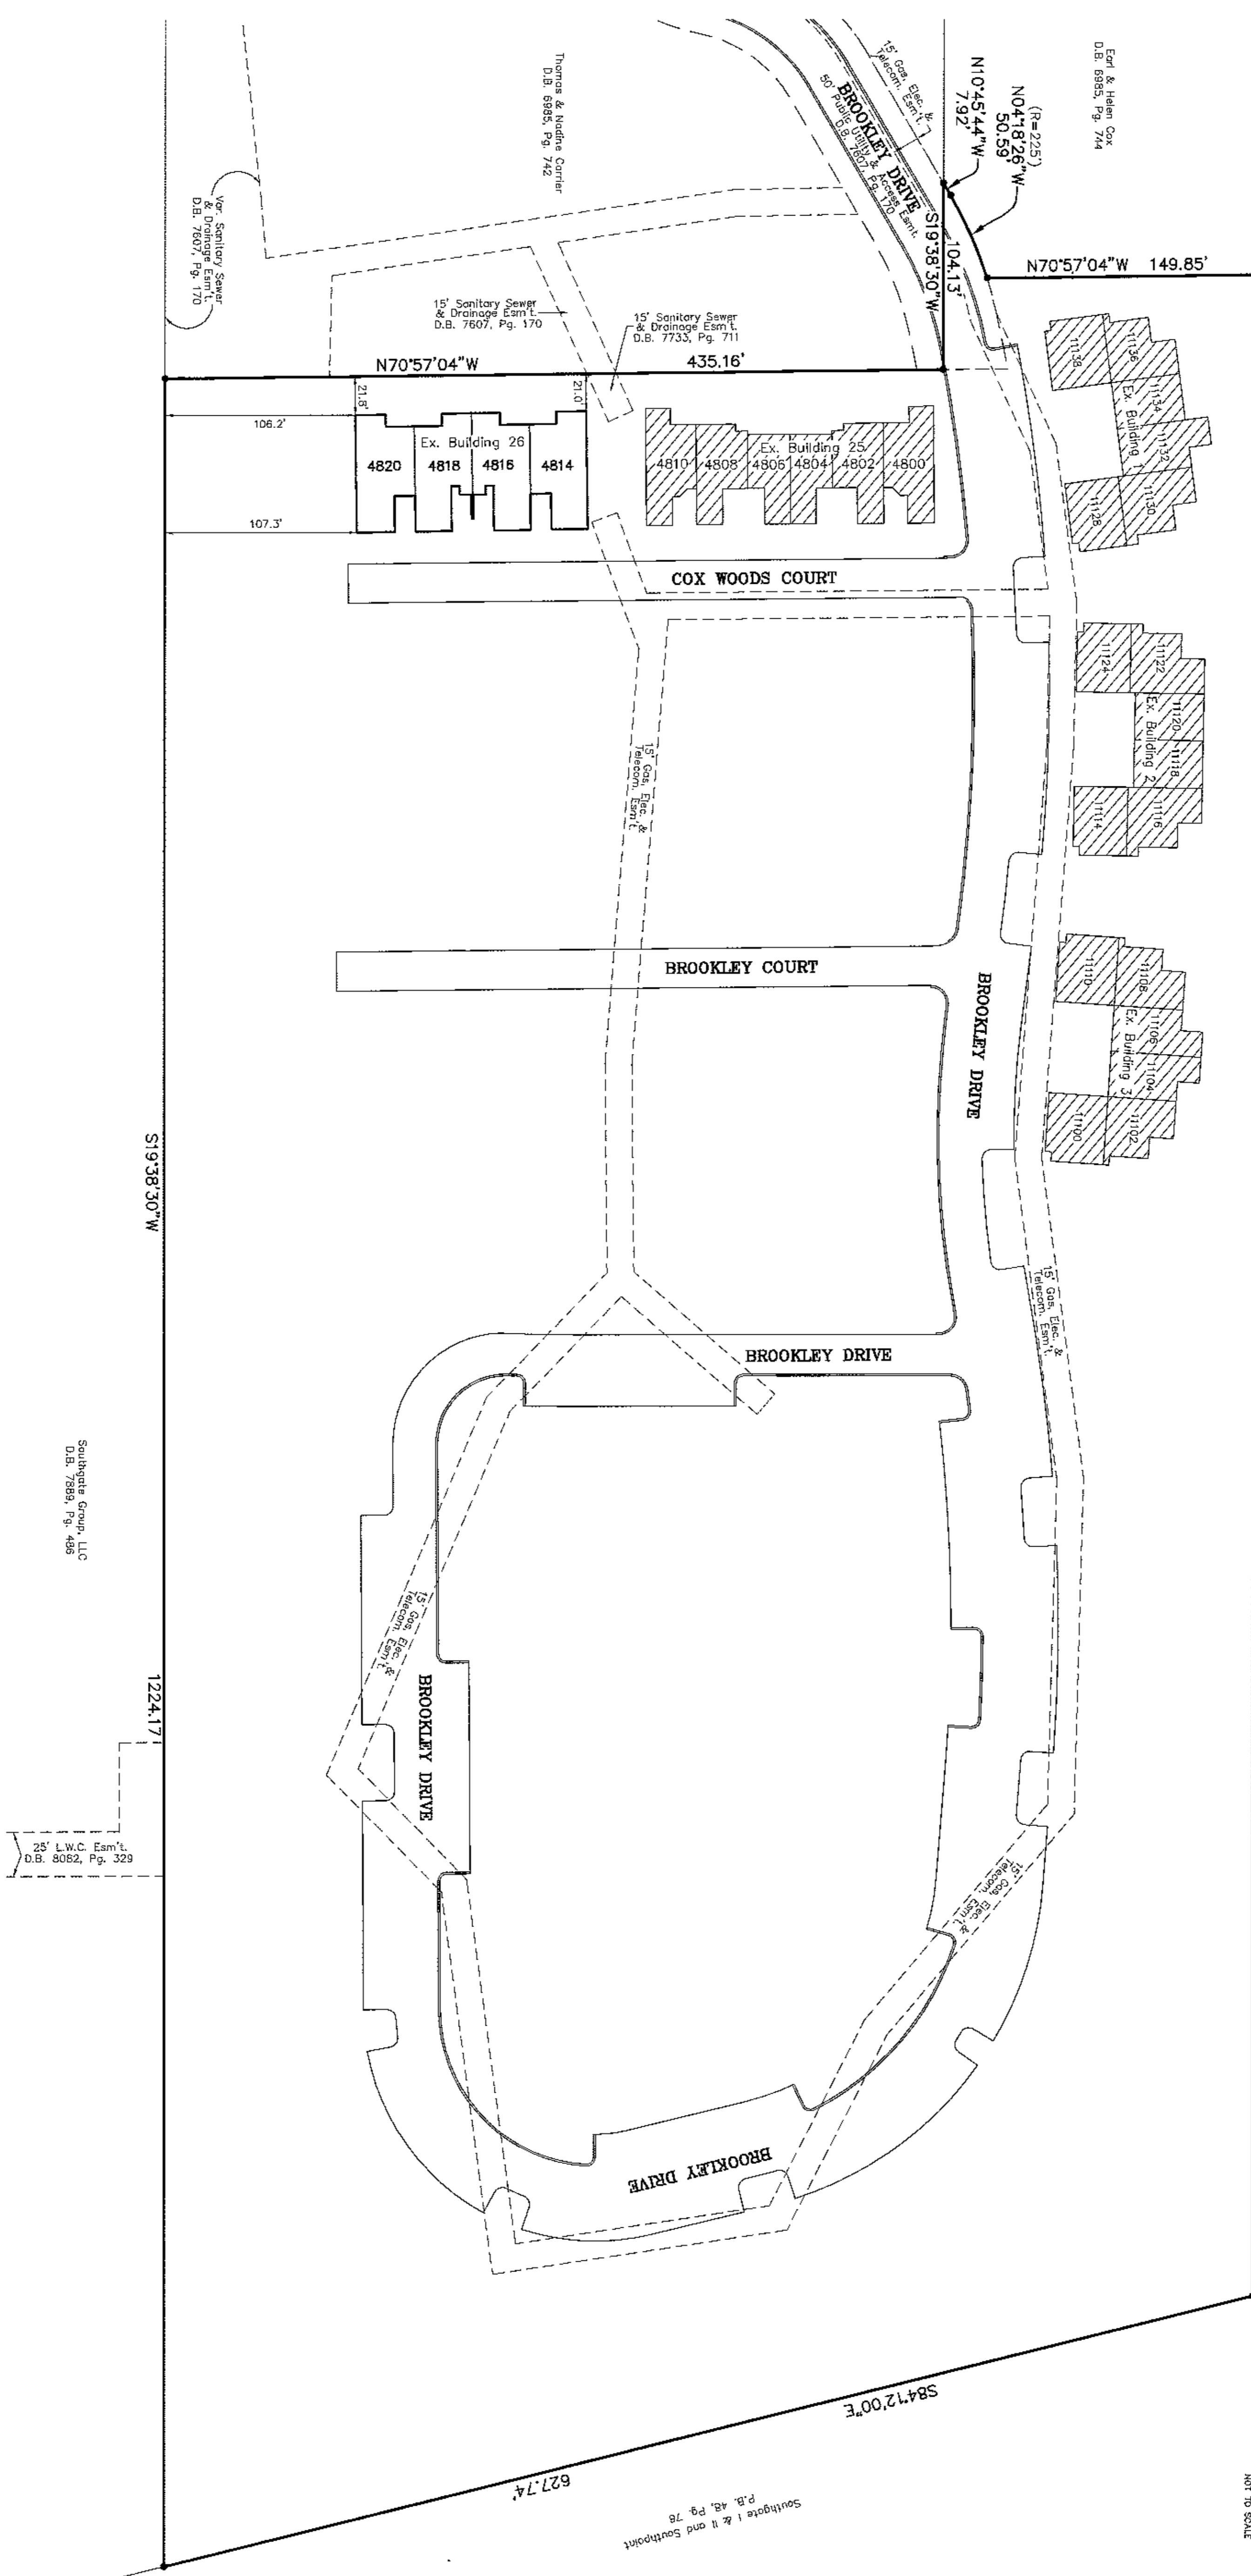

N19°38'30"E
1131.11'

Blue Link Commercial Club
D.B. 4950, Pg. 450

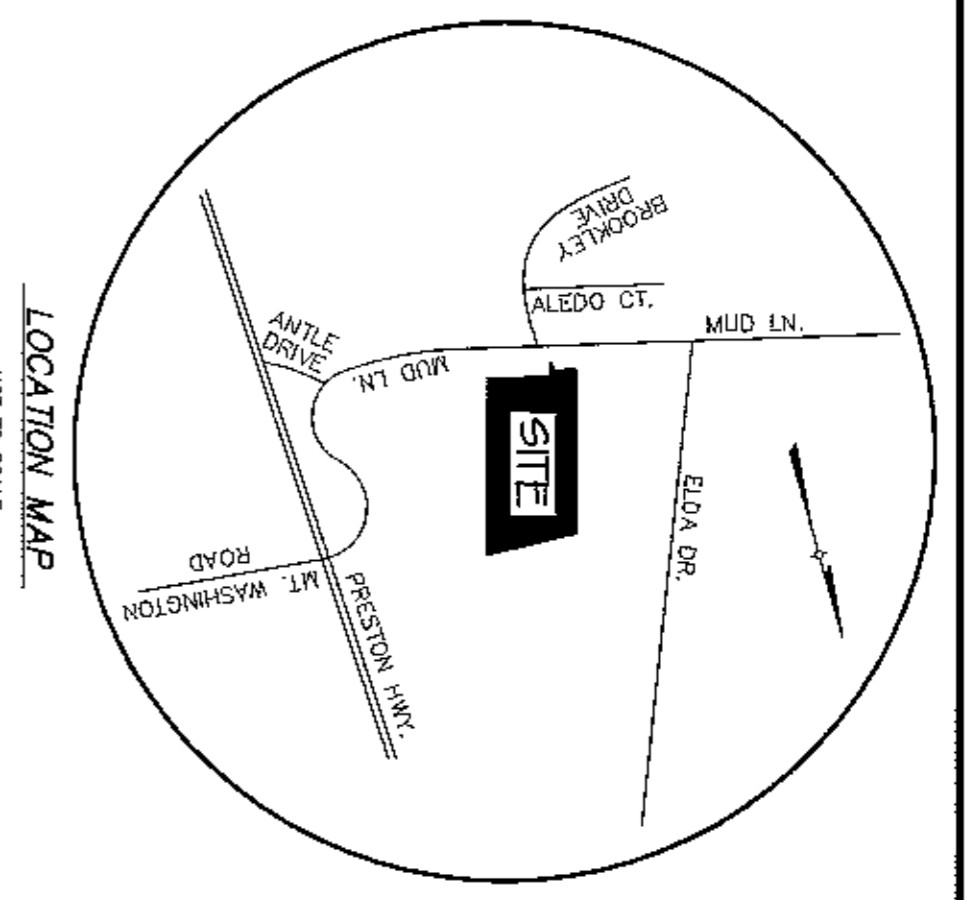

DAVID B. WINKLER
LAND SURVEYOR
#3492 6-1-05

SURVEYOR'S CERTIFICATE
I HEREBY CERTIFY THAT THE SURVEYOR'S PLAN FOR BUILDING 26 AND THE SURVEYOR'S PLAN FOR BUILDING 25 AND THE ANGULAR AND LINEAR MEASUREMENTS AND THE CENTRAL ELEVATIONS SHOWN HEREON WERE ESTABLISHED IN THE FIELD AND ARE TRUE AND CORRECT TO THE BEST OF MY KNOWLEDGE AND BELIEF. THIS SURVEY MEETS OR EXCEEDS THE STANDARD OF SURVEYING AUTHORITY.

SCOTT A. SPEARS
PROFESSIONAL ENGINEER
#10227 6-1-05

ENGINEER'S CERTIFICATE
I HEREBY CERTIFY THAT THIS IS A TRUE AND ACCURATE COPY OF THE ORIGINAL SURVEYOR'S PLAN AND ARCHITECT'S PLAN FOR BUILDING 26 AND BUILDING 25. THESE PLANS SHOW THE LOCATION, POSITION, AND DIMENSIONS OF THE UNITS AS BUILT.

JOB NO. 02006
SHEET 1 OF 2

SITE PLAN - BUILDING "26"
BROOKLEY PLACE
OWNER:
BROOKLEY PLACE, LLC
10717 BLACK WALNUT BLVD.
LOUISVILLE, KENTUCKY 40229
(502) 639-5834

LD&D
LAND DESIGN & DEVELOPMENT, INC.
ENGINEERING - LAND SURVEYING - LANDSCAPE ARCHITECTURE
204 VINE CREST AVE., SUITE B
LOUISVILLE, KENTUCKY 40222
PHONE: (502) 639-5834 FAX: (502) 639-5835

PROJECT DATA
FILE NAME: 02006condo.dwg
DATE: JUNE 1, 2005 SCALE: 1"=50'
CHECKED BY: O.Z. DRAWN BY: PDP

ENGINEER'S SEAL
SURVEYOR'S SEAL

REVISIONS			
NO.	DATE	DESCRIPTION	BY

108x57

108x57

10858

LEGEND

--- CEILING ELEVATION

--- TRAY ELEVATION

--- LIMITS OF OWNERSHIP

--- LIMITS OF COMMON SPACE (BUILDING EXTERIOR)

Recorded in Candy Book

No. 108 Page 38

Part No. 207

Issued by: LD&D

Checked by: LD&D

Drawn by: LD&D


Project No. 02006

Sheet No. 2 of 2

06632160571

FINISH GARAGE ELEV.=563.09

FINISH FLOOR ELEV.=563.99

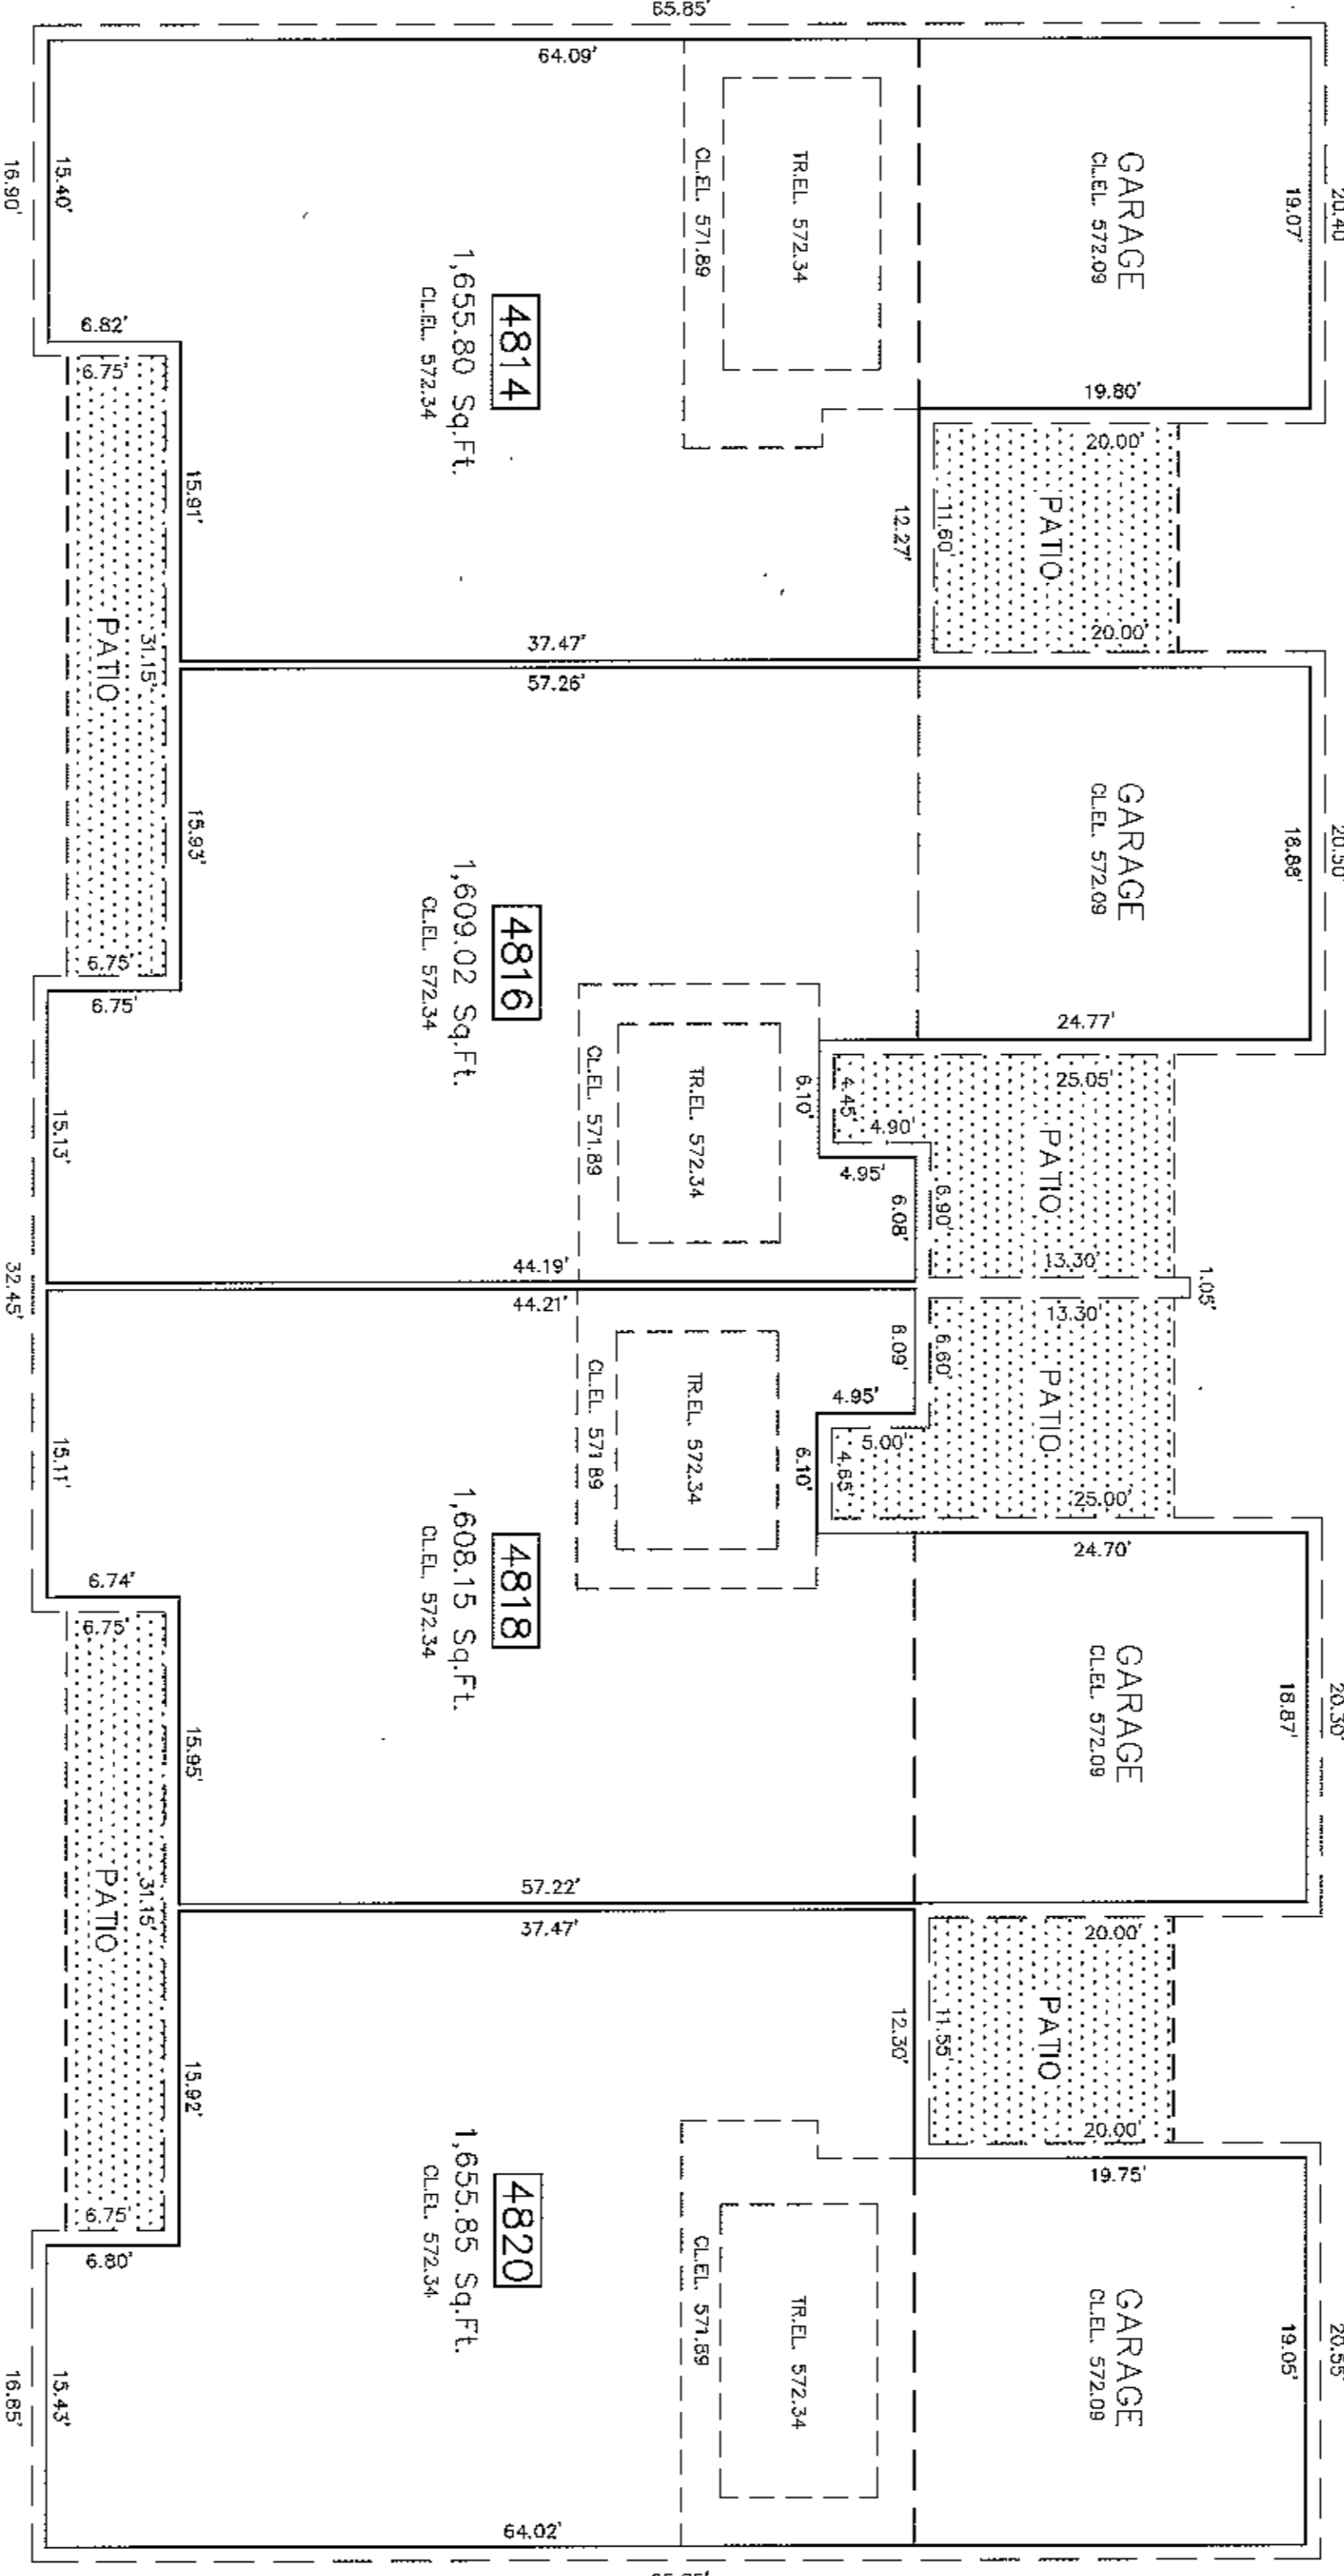

05x001

108x58

JOB NO. 02006	FLOOR PLAN - BUILDING "26"	<p>LD&D LAND DESIGN & DEVELOPMENT, INC. ENGINEERING • LAND SURVEYING • LANDSCAPE ARCHITECTURE 301 ONE CREST AVE., SUITE B LOUISVILLE, KENTUCKY 40222 PH: (502) 262-5974 FAX: (502) 262-5975</p>	PROJECT DATA	ENGINEER'S SEAL	SURVEYOR'S SEAL	<table border="1"> <thead> <tr> <th colspan="4">REVISIONS</th> </tr> <tr> <th>NO.</th> <th>DATE</th> <th>DESCRIPTION</th> <th>BY</th> </tr> </thead> <tbody> <tr><td> </td><td> </td><td> </td><td> </td></tr> <tr><td> </td><td> </td><td> </td><td> </td></tr> <tr><td> </td><td> </td><td> </td><td> </td></tr> <tr><td> </td><td> </td><td> </td><td> </td></tr> <tr><td> </td><td> </td><td> </td><td> </td></tr> </tbody> </table>	REVISIONS				NO.	DATE	DESCRIPTION	BY																				
REVISIONS																																		
NO.	DATE	DESCRIPTION	BY																															
SHEET 2 OF 2	<p>BROOKLEY PLACE</p> <p>OWNER: BROOKLEY PLACE, LLC 10717 BLACK WALNUT BLVD. LOUISVILLE, KENTUCKY 40229 (502) 639-5834</p>	<p>FILE NAME: bldg26.dwg</p> <p>DATE: JUNE 1, 2005</p> <p>CHECKED BY: O.Z.</p>	<p>SCALE: 1/8"=1'</p> <p>DRAWN BY: PDP</p>																															

108x58